

NOTES:

- 1) THIS PLAN REFERS TO SHERBORN PROPERTY ID: MAP 8 LOT 136
2) DEED REFERENCE: BOOK 67128 PAGE 535
3) PLAN REFERENCE: PLAN #1016 OF 1997
4) TOPOGRAPHICAL INFORMATION TAKEN FROM A PLAN BY GLM ENGINEERING CONSULTANTS, INC. DATED 8/28/16 AND IS NOT THE RESULT OF A FIELD SURVEY BY THIS OFFICE

DESIGN INFORMATION

DATE SOIL TESTING UNDERTAKEN: VARIES
DESIGN RATE: 15 MPI
DAILY FLOW: 440 GPD

SCHEDULE OF ELEVATIONS:	PROPOSED	ASBUILT
INVERT AT FOUNDATION	104.00	106.35
INVERT AT S. TANK INLET	103.75	104.10
INVERT AT S. TANK OUTLET	103.50	103.85
INVERT AT D. BOX INLET	95.25+/- EX.	94.83
INVERT AT D. BOX OUTLET	EXISTING	
INVERT AT BEGIN. OF TRENCH	N.A.	
INVERT AT END OF TRENCH	N.A.	
ELEV. OF GROUND WATER	N.A.	

SYSTEM COMPONENT TIE INFORMATION:

BUILDING CORNER:	A	B	C
COMPONENT:			
CTR. END S TANK	44.5'	21.8'	---
CTR. END S TANK	36.1'	29.4'	---
CTR. DIST. BOX	172.9'	---	44.1'



LEGEND:

100	EXISTING CONTOUR ELEVATION	100.0	PROPOSED CONTOUR ELEVATION
100.0	EXISTING SPOT ELEVATION	100.0	PROPOSED SPOT ELEVATION
---	EXISTING STONE WALL	---	PROPOSED DRAIN LINE
---	EXISTING FENCE	---	PROPOSED FORCE MAIN (DESIGN BY OTHERS)
---	EXISTING DECIDUOUS TREE		
---	EXISTING DECIDUOUS TREE (SPECIES VARY)		
1	HOUSE NUMBER		
---	EXISTING EDGE OF BIT. CONC. PAVEMENT		
---	EXISTING EDGE OF BORDERING VEGETATED WETLANDS		
---	EXISTING TREE LINE		
---	EXISTING STRUCTURE		
o	EXISTING CLEAN OUT LOC.		

REVISION:

NO.	DATE	DESCRIPTION	BY

I CERTIFY THAT THE SOIL ABSORPTION SYSTEM HAS BEEN CONSTRUCTED IN ACCORDANCE WITH 310 CMR 15.00, THE APPROVED DESIGN PLANS AND ALL LOCAL REGULATIONS AND THAT ANY CHANGES TO THE DESIGN PLANS HAVE BEEN REFLECTED ON THIS ASBUILT PLAN

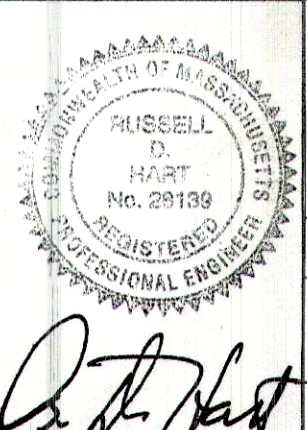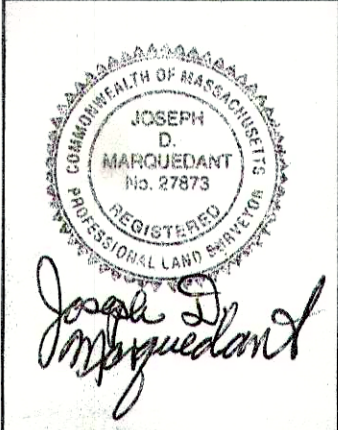

SHEET 1 OF 1 "ASBUILT" #5918

BOARD OF HEALTH PLOT PLAN
SHERBORN MASSACHUSETTS
16 NASON HILL LANE
PARCEL - ID: MAP 8 LOT 136
PROPOSED CONDITIONS PLAN OF LAND

PREPARED FOR: MICHAEL NEWMAN
16 NASON HILL LANE
SHERBORN MA

J.D. MARQUEDANT & ASSOCIATES INC.
LAND SURVEYING
6 WALCOTT STREET HOPKINTON MA
PHONE: 508-435-4145 FAX: 508-435-0157

SCALE: 1"=40'

DATE: OCT. 26, 2018

DRAWN BY:

CHECKED BY:

OWNER : MICHAEL NEWMAN
16 NASON HILL LANE
SHERBORN MA