

NOTES:

- 1) THIS PLAN REFERS TO SHERBORN PROPERTY ID: MAP 8 LOT 136
2) DEED REFERENCE: BOOK 67128 PAGE 535
3) PLAN REFERENCE: PLAN #1016 OF 1997
4) TOPOGRAPHICAL INFORMATION TAKEN FROM A PLAN BY GLM ENGINEERING CONSULTANTS, INC. DATED 8/28/16 AND IS NOT THE RESULT OF A FIELD SURVEY BY THIS OFFICE

106.35
104.10
103.85
94.83

SYSTEM COMPONENT TIE INFORMATION:

BUILDING CORNER:	A	B	C
COMPONENT:			
CTR. END S TANK	44.5'	21.8'	---
CTR. END S TANK	36.1'	29.4'	---
CTR. DIST. BOX	172.9'	---	44.1'

LEGEND:

	EXISTING CONTOUR ELEVATION		EXISTING FORCE MAIN (DESIGN BY OTHERS)
	EXISTING SPOT ELEVATION		EXISTING WATER LINE
	EXISTING STONE WALL		
	EXISTING FENCE		
	EXISTING EVERGREEN TREE		
	EXISTING DECIDUOUS TREE (SPECIES VARY)		
	HOUSE NUMBER		
	EXISTING EDGE OF BIT. CONC. PAVEMENT		
	EXISTING EDGE OF BORDERING VEGETATED WETLANDS		
	EXISTING TREE LINE		
	EXISTING STRUCTURE		
	EXISTING CLEAN OUT LOC.		


REVISION:

1	6/17/19	AS-BUILT FINAL GRADES	
2	6/19/19	AS-BUILT POOL FORCE MAIN	

NO.	DATE	DESCRIPTION	BY

I CERTIFY THAT THE SOIL ABSORPTION SYSTEM HAS BEEN CONSTRUCTED IN CONFORMANCE WITH 310 CMR 15.00, THE APPROVED DESIGN PLANS AND ALL LOCAL REGULATIONS AND THAT ANY CHANGES TO THE DESIGN PLANS HAVE BEEN REFLECTED ON THIS ASBUILT PLAN.

I CERTIFY THAT THE FINAL GRADES HAVE BEEN CONSTRUCTED IN CONFORMANCE WITH 310 CMR 15.00, THE APPROVED DESIGN PLANS AND ALL LOCAL REGULATIONS AND THAT ANY CHANGES TO THE DESIGN PLANS HAVE BEEN REFLECTED ON THIS ASBUILT PLAN

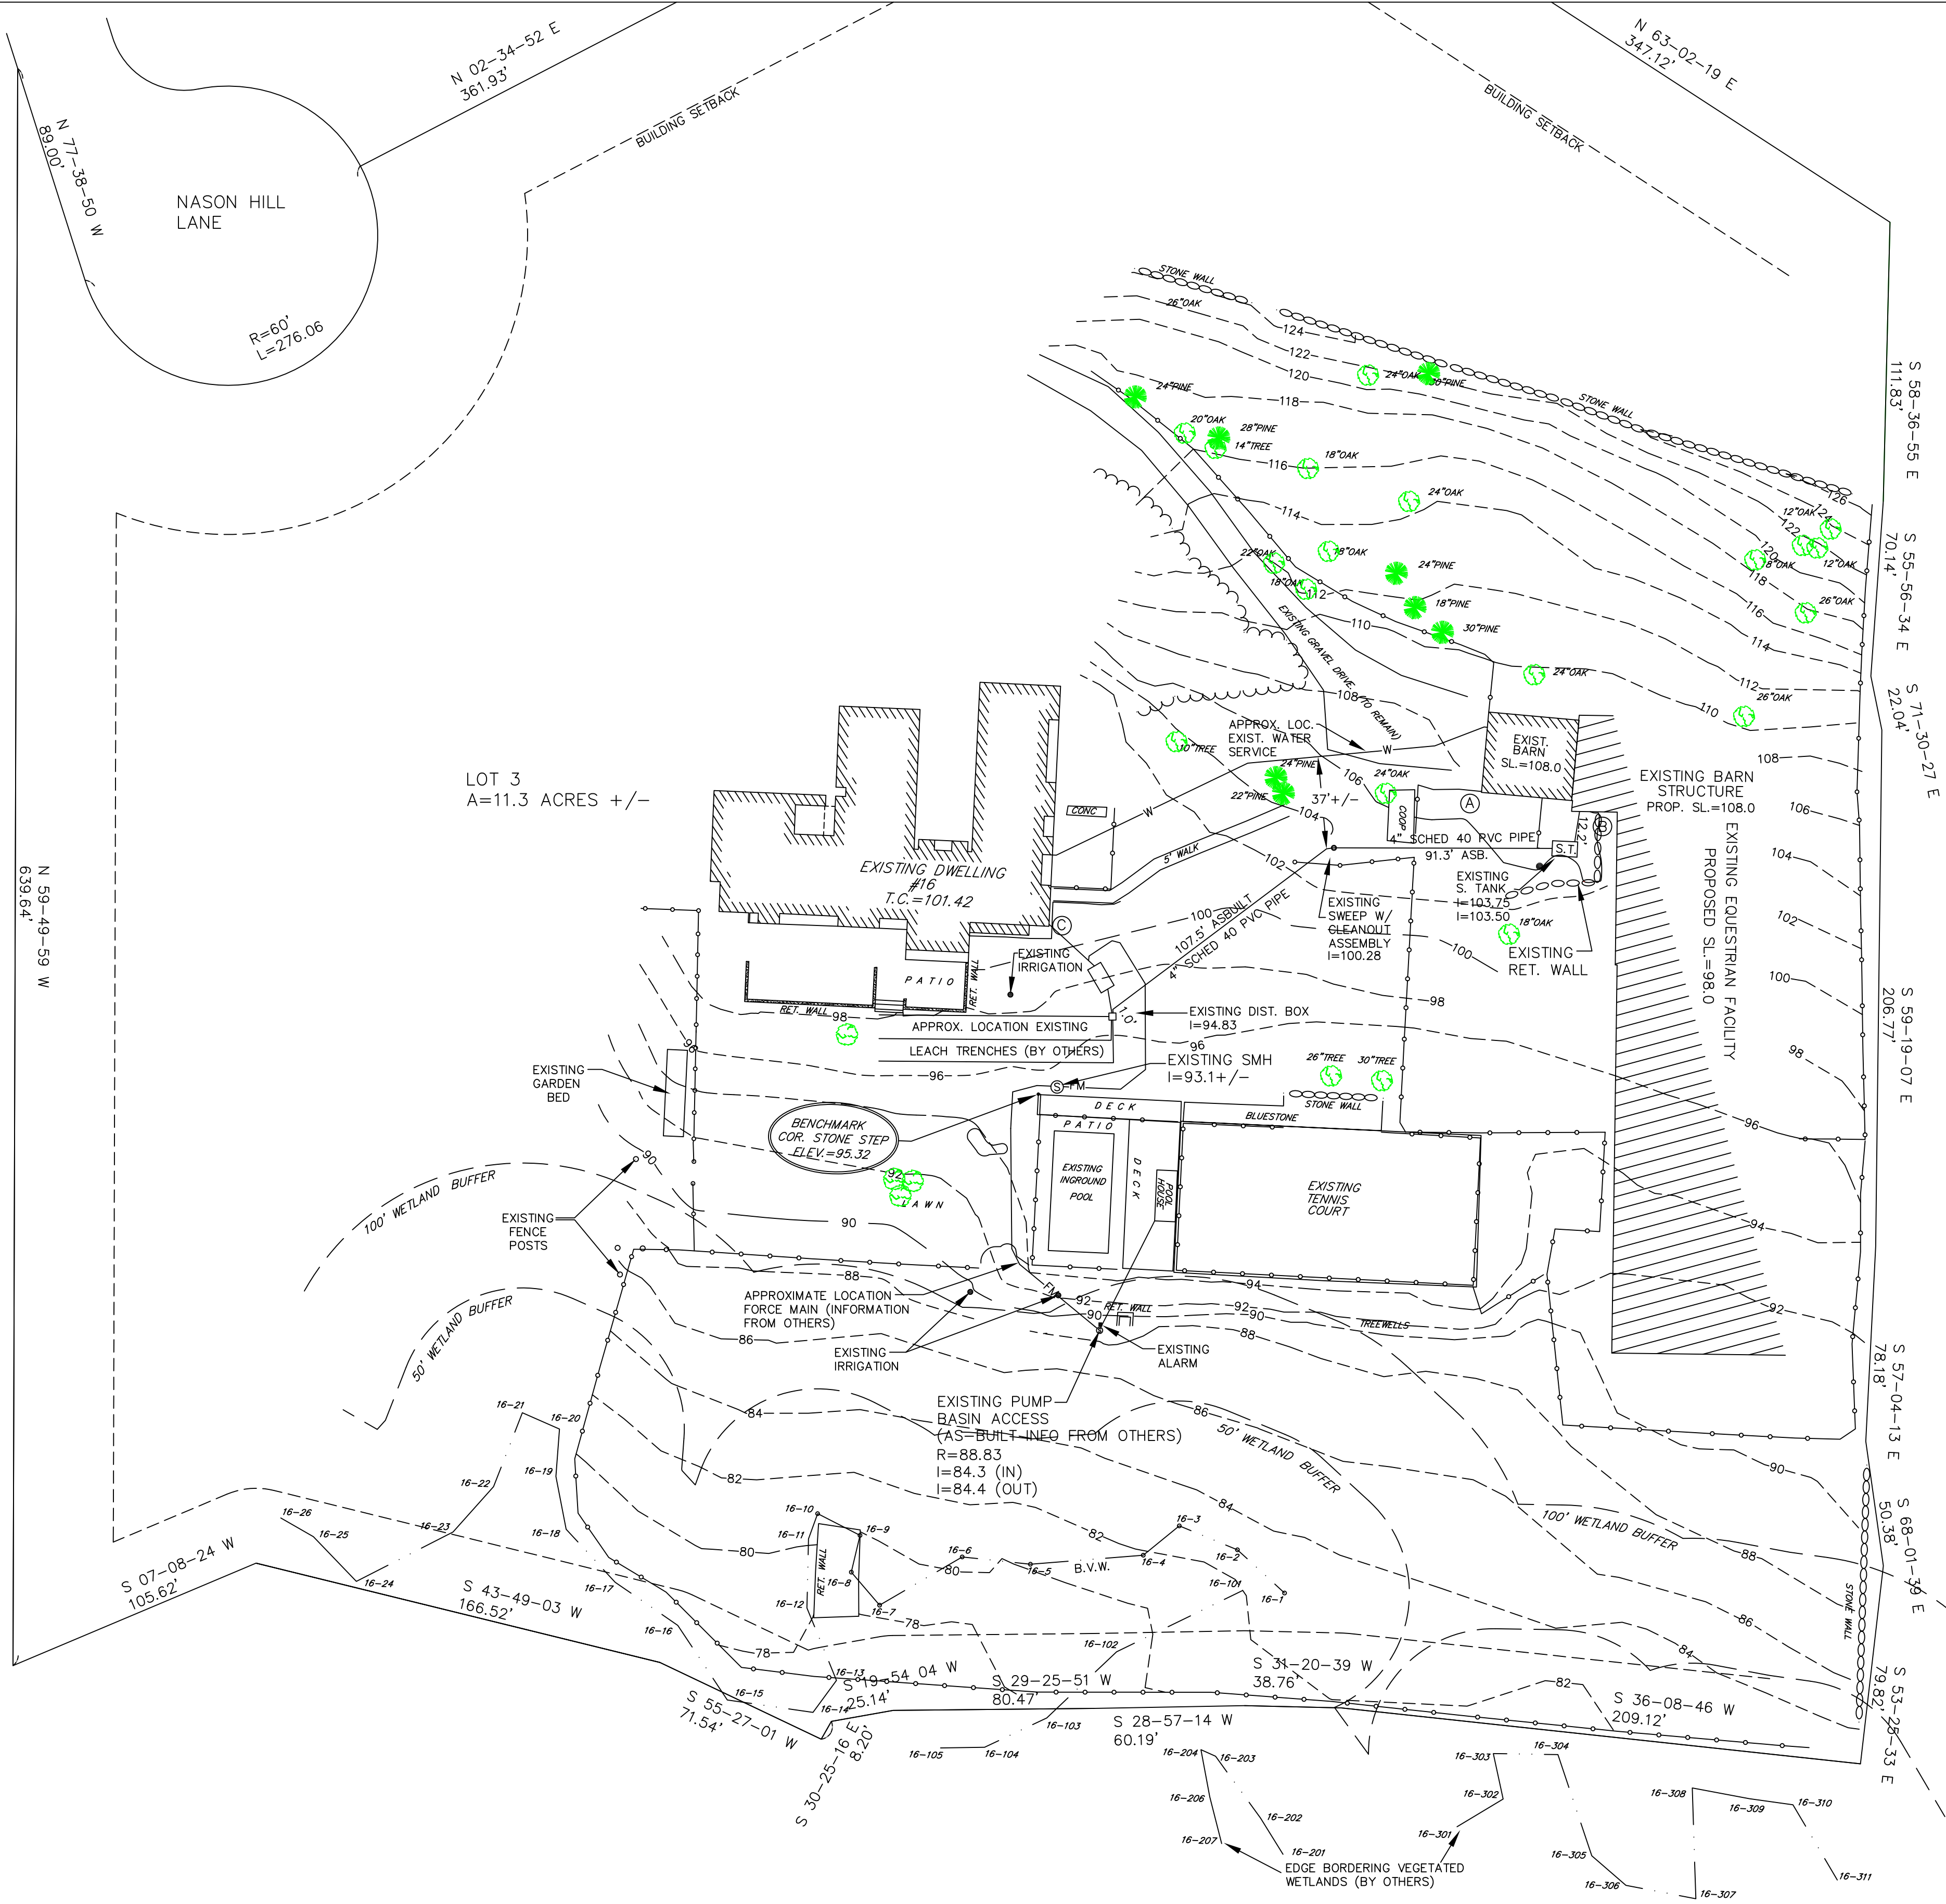

OWNER : MICHAEL NEWMAN
16 NASON HILL LANE
SHERBORN MA

SHEET 1 OF 1

#5918

J.D. MARQUEDANT & ASSOCIATES INC.
LAND SURVEYING
6 WALCOTT STREET HOPKINTON MA
PHONE: 508-435-4145 FAX: 508-435-0157

PREPARED FOR: MICHAEL NEWMAN
16 NASON HILL LANE
SHERBORN MA

SCALE: 1"=40'

DATE: JUNE 21, 2019

DRAWN BY:

CHECKED BY: