


NOTES:


- PUMP NOT INSTALLED AT TIME OF INSPECTION. GLM WILL NEED TO INSPECT PUMP INSTALLATION ONCE COMPLETED.
- INSTALLER AND/OR APPLICANT MUST CONFIRM WITH ENGINEER THAT ONLY WASTEWATER FROM THE POOL HOUSE IS CONNECTED TO NEW PUMP BASIN.

NOTWITHSTANDING BACKFILLING OF THE SEPTIC SYSTEM OR FINISH GRADING OVER AND ADJACENT TO THE FORCE MAIN, THIS FIRM DID ON 2/2/18 & 2/21/18 INSPECT THE PUMP BASIN & FORCE MAIN, AND FOUND THEM TO BE SUBSTANTIALLY LOCATED AND CONSTRUCTED IN COMPLIANCE WITH THE TERMS OF THE PERMIT, THE REQUIREMENTS OF THE BOARD OF HEALTH, COMMONWEALTH OF MASSACHUSETTS TITLE 5 AND THE APPROVED PLAN DATED 3/22/16 & REVISED 5/2/16.

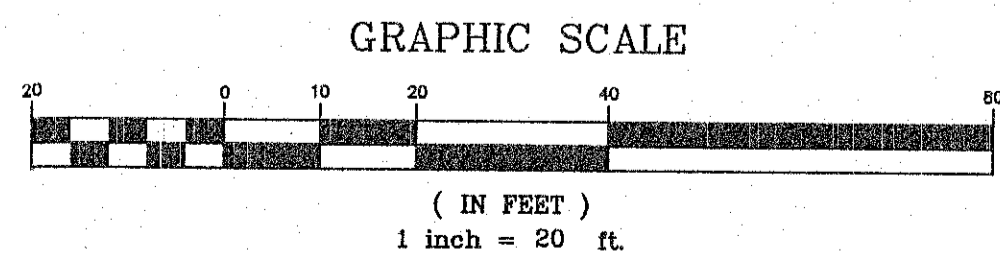

GLM Engineering Consultants, Inc.
19 EXCHANGE STREET
HOLLISTON, MA 01746
P: 508-429-1100 F: 508-429-7160
www.GLMengineering.com

FLD.:
DRW.: JMN
CHKD.: JMN

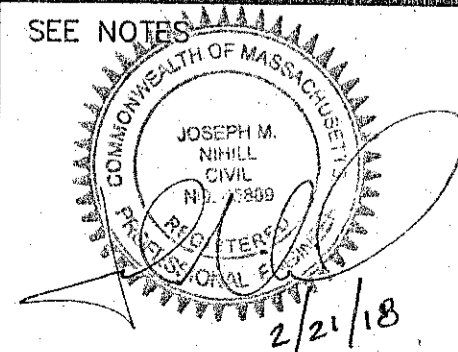

PUMP BASIN & FORCE MAIN AS-BUILT PLAN
16 NASON HILL LANE
SHERBORN, MASSACHUSETTS
FOR
MIKE NEWMAN
16 NASON HILL LANE
SHERBORN, MA 01770

JOB No. 15,726
DATE: 2/21/18
SCALE: 1"=20'
SHEET: 1 of 1